

STATE OF UTAH  
DEPARTMENT OF NATURAL RESOURCES  
DIVISION OF OIL, GAS AND MINING  
1594 West North Temple - Suite 1210  
Box 145801  
Salt Lake City, Utah 84114-5801  
Telephone: (801) 538-5291  
Fax: (801) 359-3940

SMALL MINING OPERATIONS 2009 PROGRESS REPORT  
January 1, 2009 to December 31, 2009

The information required in this form are based on provisions of the Mined Land Reclamation Act, Title 40-8, and the rules as under the Utah Minerals Regulatory Program.

1. Mine Permit Number: M-041-009 m/0411/0009
2. Mine Name: GEORGIA-PACIFIC GYPSUM
3. Name of Operator/Permittee: GEORGIA-PACIFIC GYPSUM LLC  
Note: If Operator's address, company representative or phone number have changed, please provide a replacement page for the Notice of Intention together with form MR-REV available on the Division's web page at [https://fs.ogm.utah.gov/pub/MINES/Minerals\\_Related/FORMS/MR-REV-SMO\\_EXP.pdf](https://fs.ogm.utah.gov/pub/MINES/Minerals_Related/FORMS/MR-REV-SMO_EXP.pdf)
4. Mine Location: SEVIER COUNTY NW 1/4 SE 1/4 SECTION 7-TWP 23S-R1W
5. Report the gross amount of ore mined and waste moved, as well as the current disposition of the material (sold, stockpiled, regraded, etc.):

Gross Ore Mined 0 Tons, or 0 yd<sup>3</sup>  
Waste Material Moved 0 Tons, or 0 yd<sup>3</sup>  
New Disturbance 0 Acres during 2009  
Area Reclaimed 21.33 Acres during 2009  
Total Disturbed Area 26.82 Acres\*

\*Total life of mine disturbance to the end of 2009.

Was the ore shipped off site? If not, where is the ore located? NO MINING  
ACTIVITY IN 2009 - RECLAMATION ONLY

Where is the waste located? N/A


6. Briefly describe the reclamation work performed during the past year. A map showing reclaimed areas and dates is suggested. (Submit form MR-SITE ([https://fs.ogm.utah.gov/pub/mines/minerals\\_related/forms/MR-SITE.pdf](https://fs.ogm.utah.gov/pub/mines/minerals_related/forms/MR-SITE.pdf)) for an application for full or partial bond/site release).  
RECLAIMED PREVIOUSLY MINED AREAS, LYNN KUNZLER WITH LITDCGM  
MONITORER RECLAMATION WORK.  
AREAS A THRU J WERE RECLAIMED IN 2009 - SEE ATTACHES MAPS

I hereby certify, under penalties of law, the information provided in this report is true and correct to the best of my knowledge and belief.


Name (Typed or Print): THOMAS C. BROOKS  
Title of Operator: GEOLOGIST/MINING RESOURCE  
Signature of Operator: [Signature]  
Date: FEB 15, 2010



## Georgia-Pacific Crescent Claims

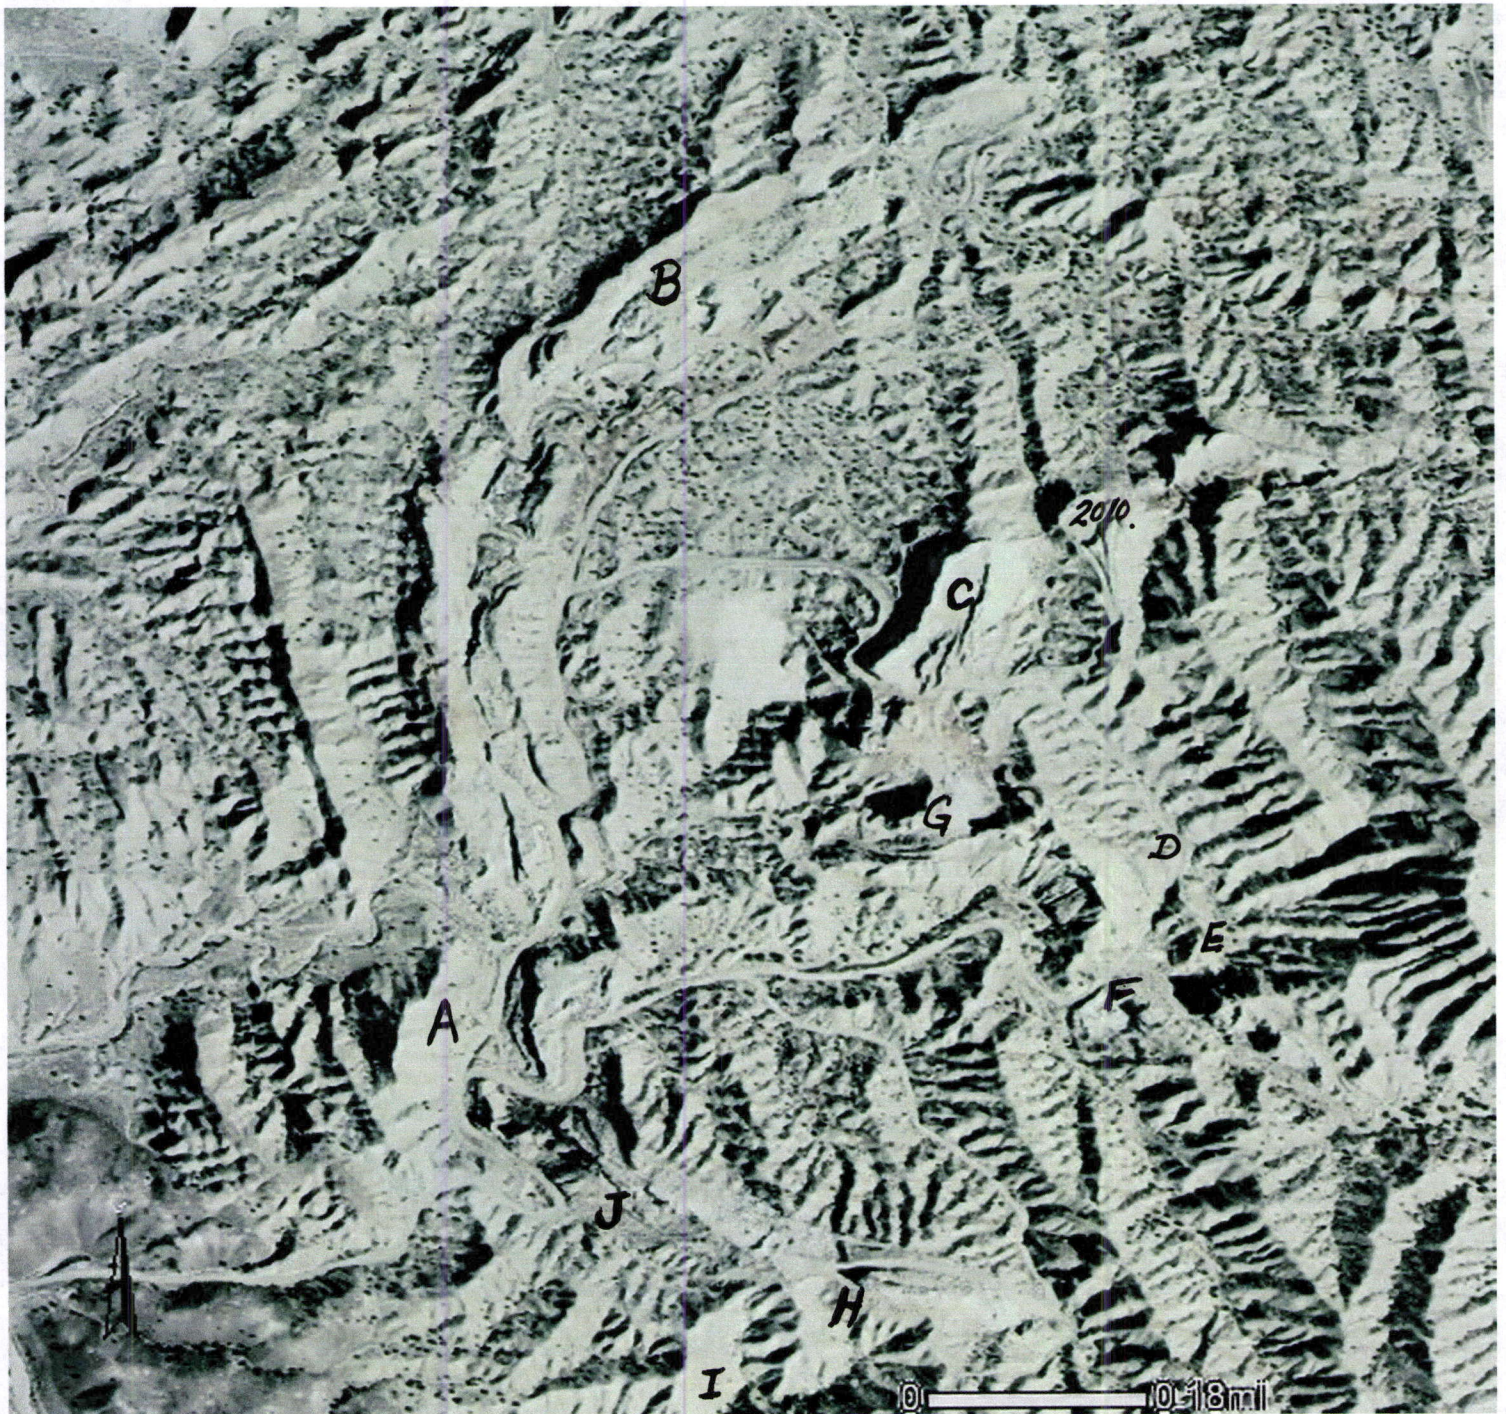


North Quarry Reclamation Areas 2009

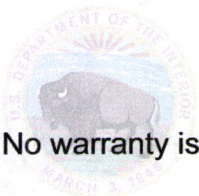


2/16/2010

No warranty is made by the BLM for the use of the data for purposes not intended by the BLM.

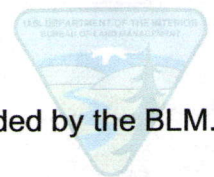




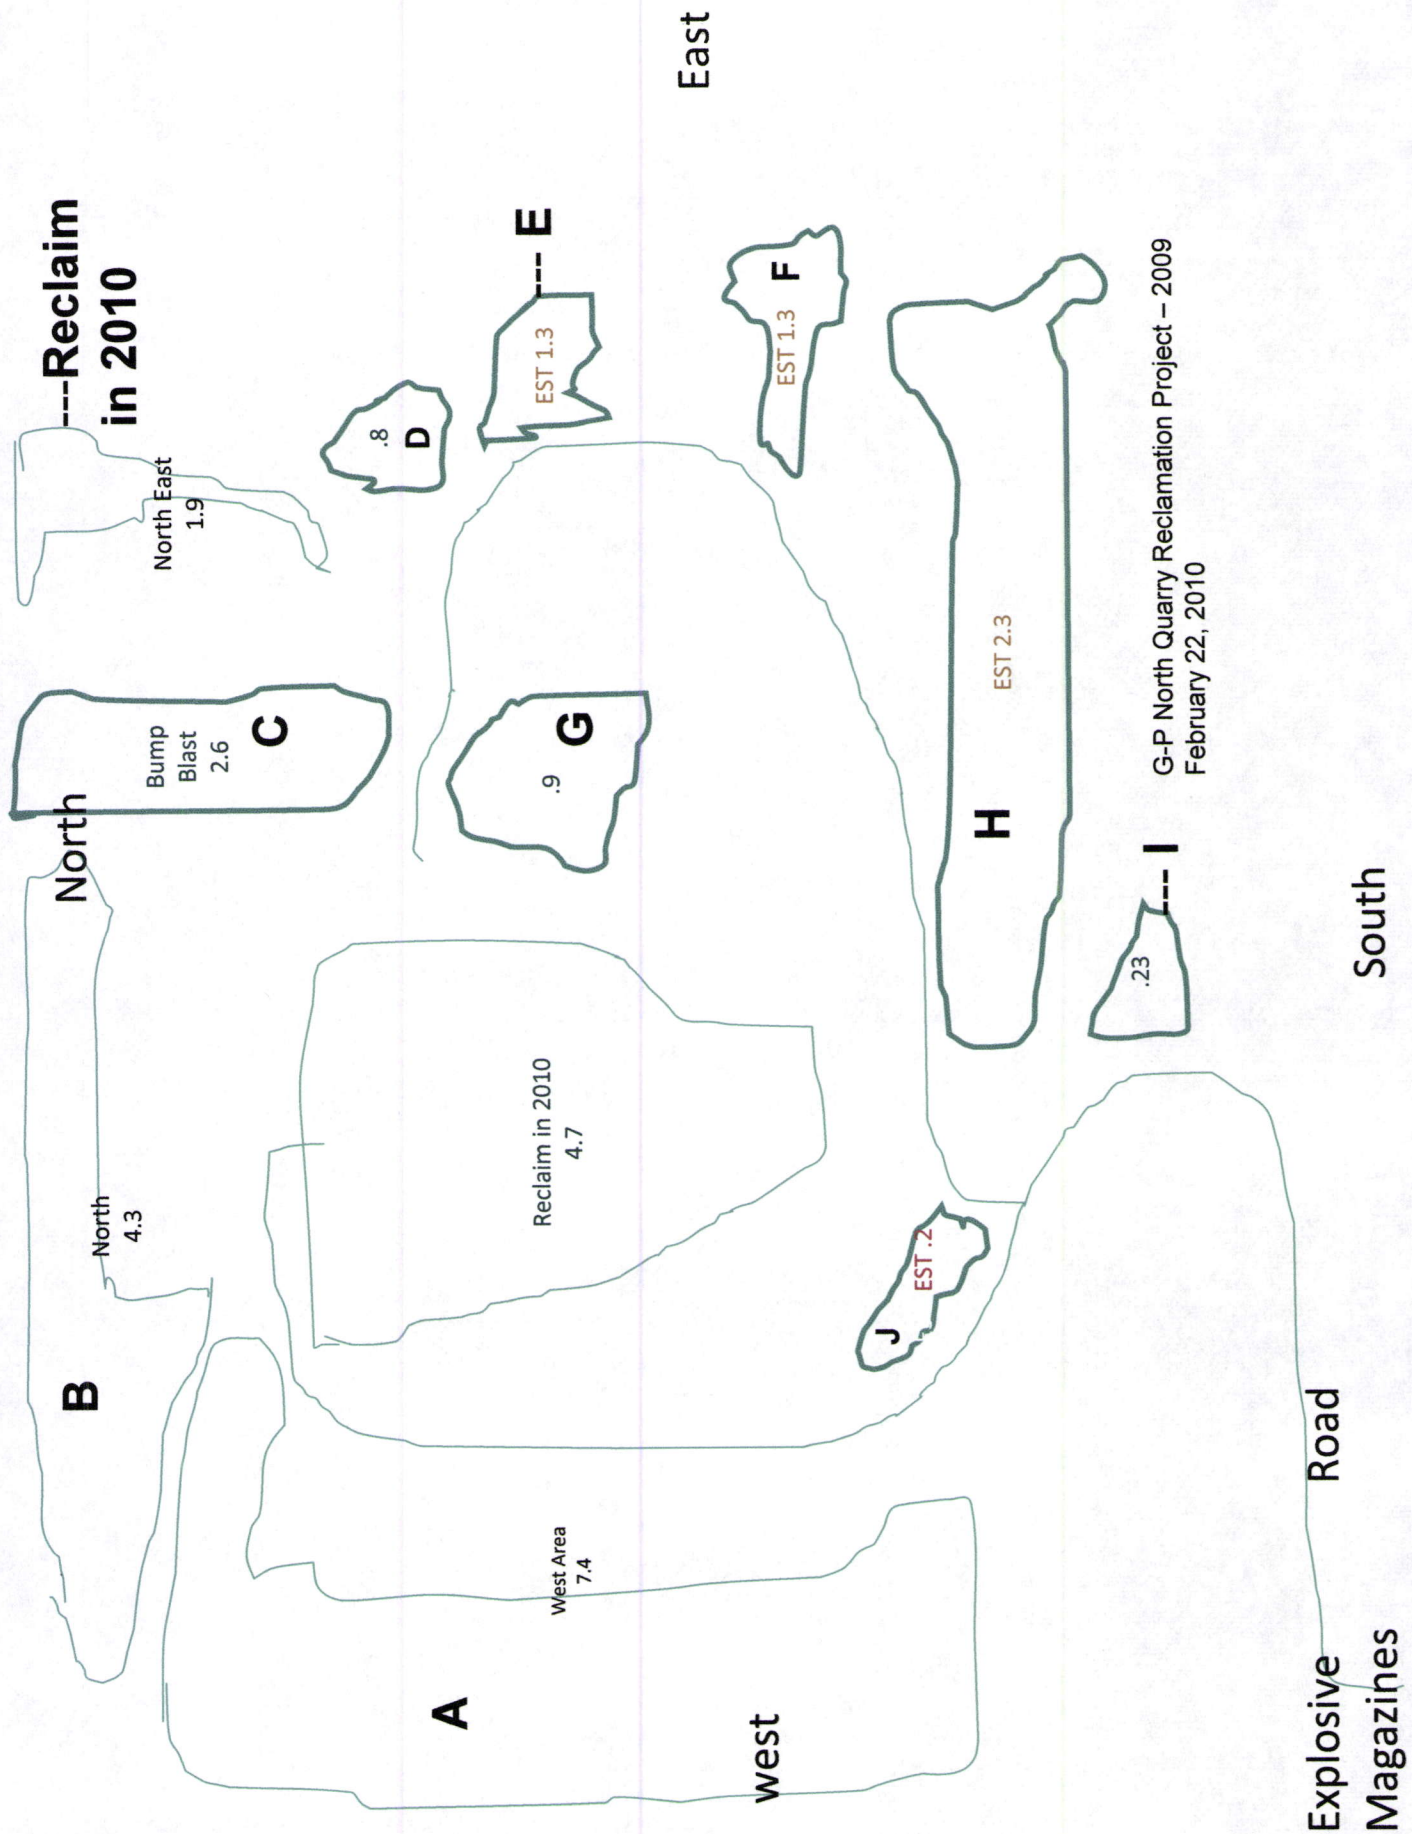

G-P North Quarry Reclamation Project – 2009  
February 22, 2010



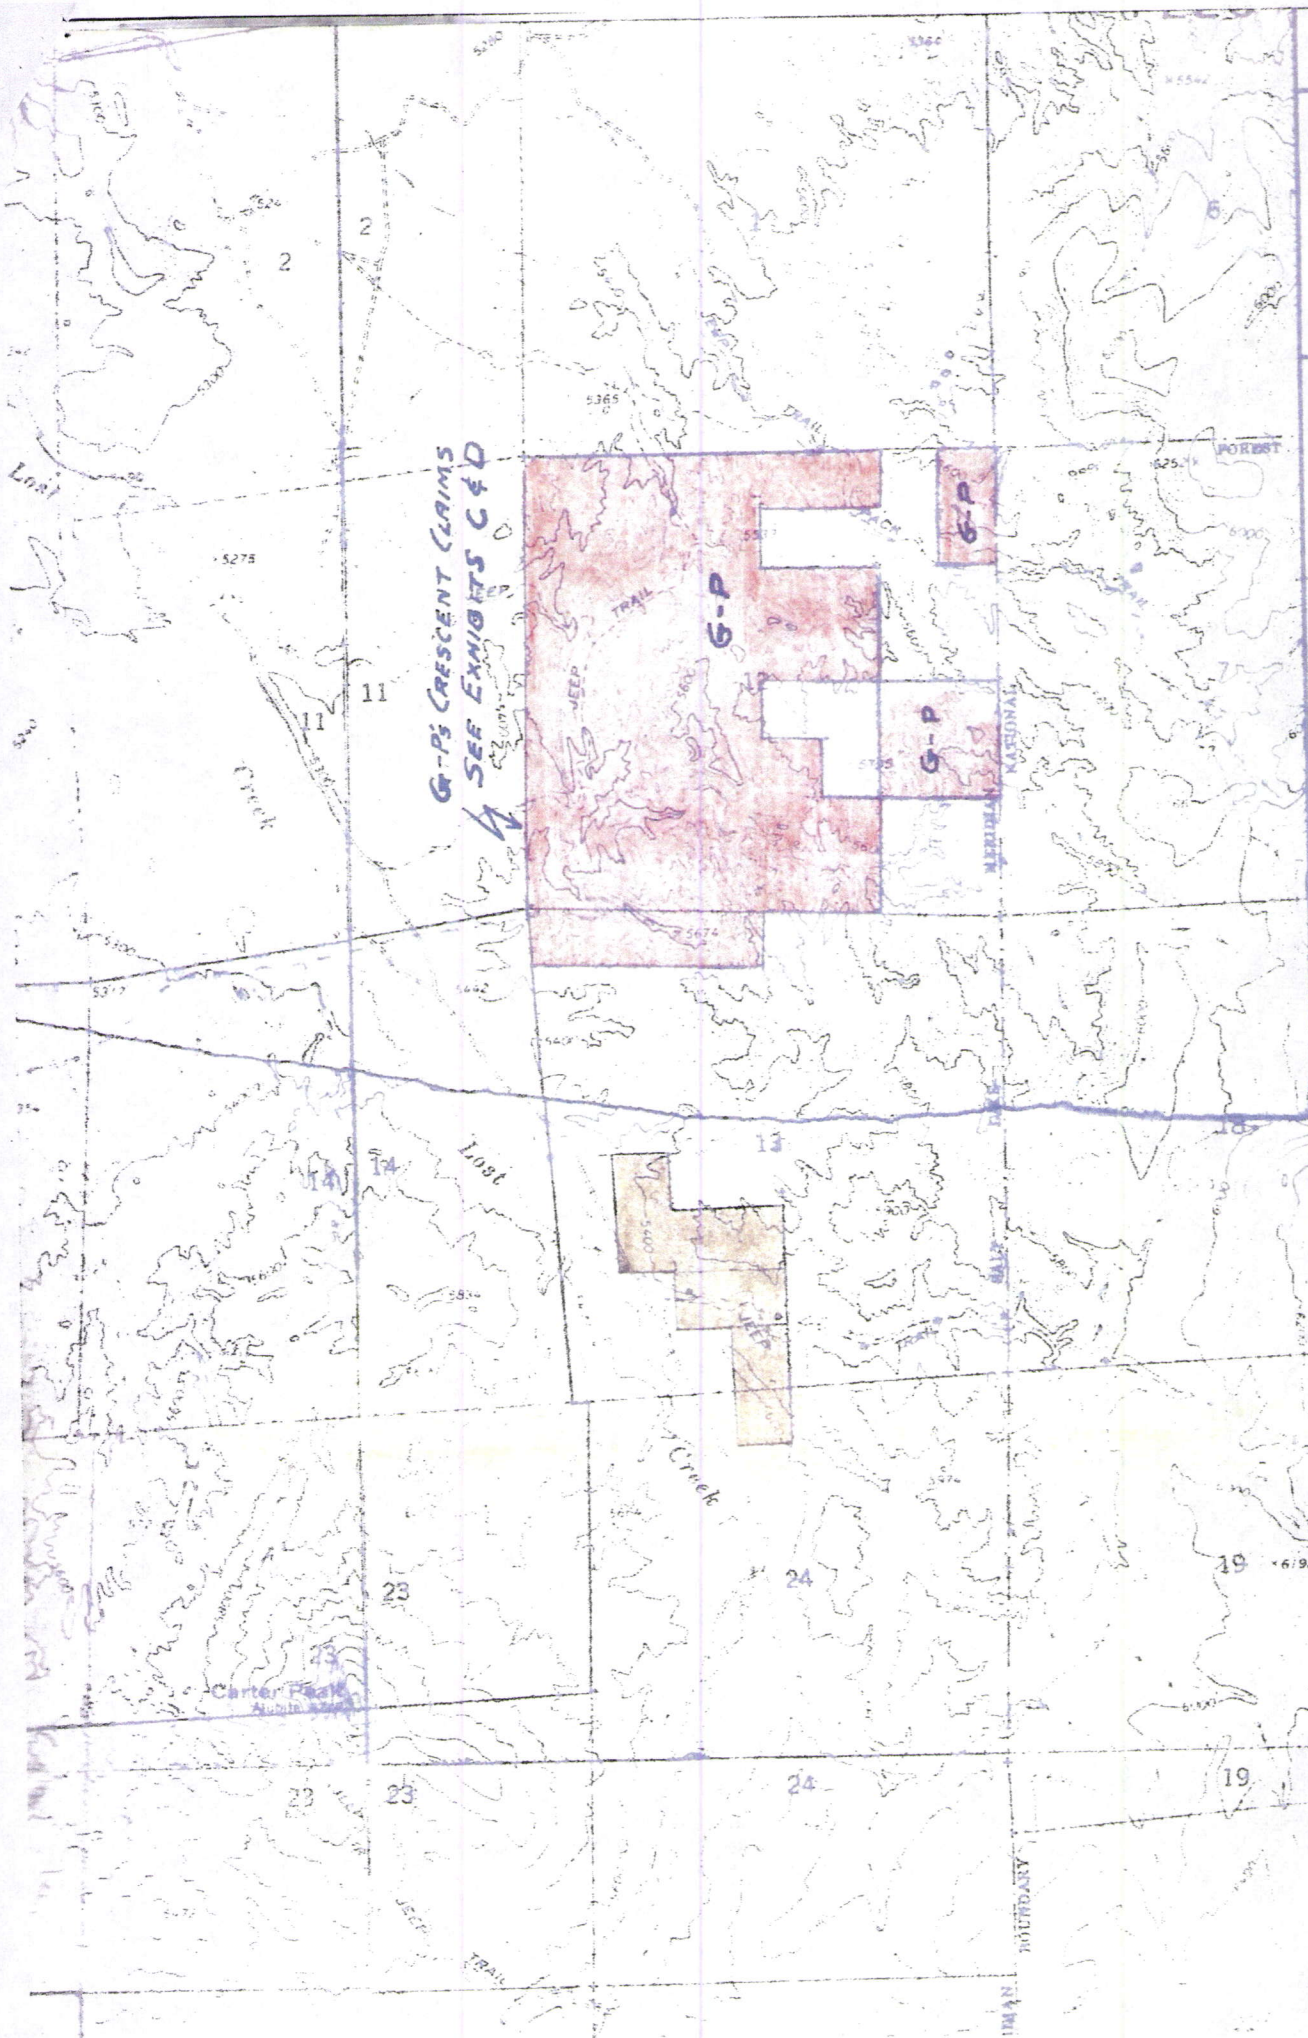

SCALE 1"=2000'		DRAWN EJC		CHECKED		APPROVED		DATE June 8, 1977		PLANT	
<b>GEORGIA-PACIFIC CORPORATION</b>										OREGON	
GYPSUM DIVISION ENGINEERING DEPARTMENT										PORTLAND	
REVISION		DESCRIPTION		BY		DATE					





**Georgia-Pacific Gypsum LLC**

PO Box 337350  
N. Las Vegas, NV 89033  
Telephone: 702-643-8100  
Fax 702-643-2049

---

Darron Haddock  
Utah Division of Oil, Gas and Mining  
1594 West North Temple, Suite 1210  
Salt Lake City, UT 84116

February 19, 2010

RE: Georgia-Pacific Gypsum LLC  
Gypsum Quarries 2009 Annual Reports for  
M-041-009, M-015-072, M-015-050

Dear Mr. Haddock:

Attached are the 2009 annual reports for Georgia-Pacific Gypsum LLC's gypsum quarries. Each report has updated maps attached. The Hebe and Eagle Canyon (Moore) Quarries were reclaimed in 2008 and seeding completed in 2009. Both were starting to show new vegetation growth when I visited them in the fall of 2009. 21.3 acres of the Crescent Quarry, also referred to as the Georgia-Pacific Quarry, were reclaimed in 2009. The remaining 5.5 acres will be reclaimed in the first quarter of 2010 and the total disturbed area of 26.82 acres will be seeded as well.

Please contact me if you have any questions or need additional information. Thank you.

Sincerely,

Thomas C. Brooks  
5512 Star Cactus Ave.  
Las Vegas, NV 89131

Cell: (702) 845-9714  
E-mail: [tcbrooks@gapac.com](mailto:tcbrooks@gapac.com)

**RECEIVED**

**MAR 01 2010**

**DIV. OF OIL, GAS & MINING**